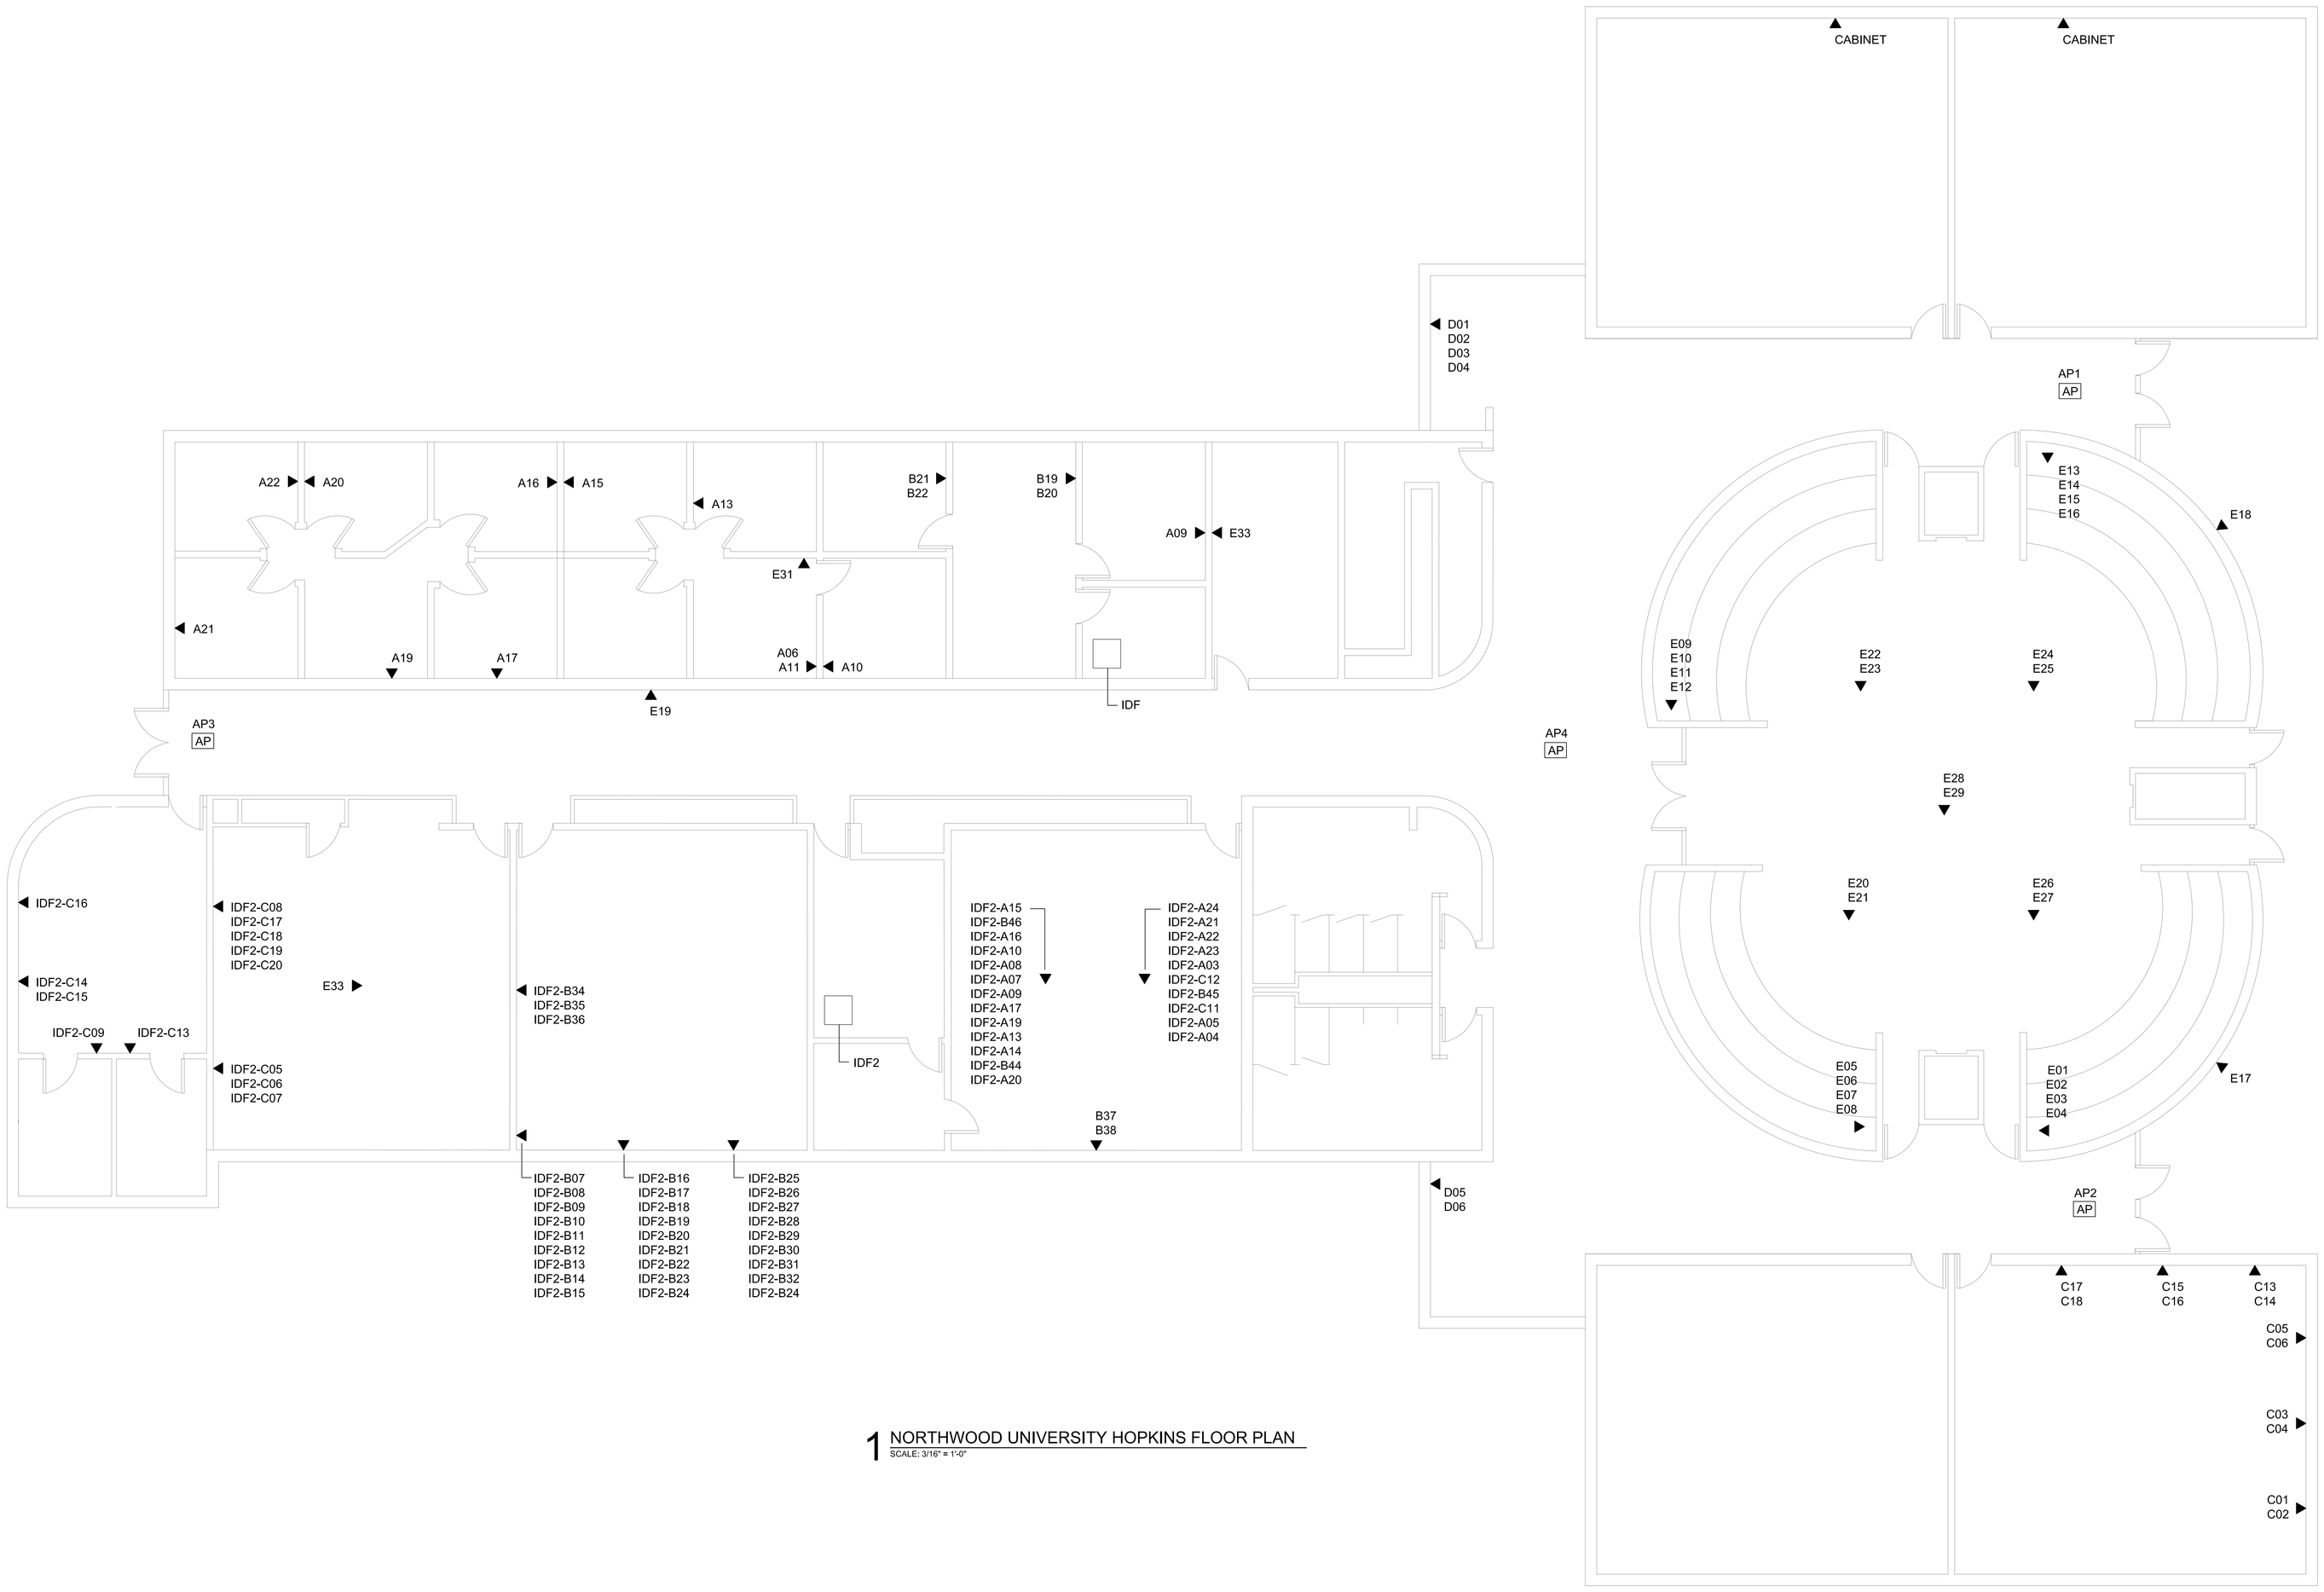

1 NORTHWOOD UNIVERSITY HOPKINS FLOOR PLAN
SCALE: 3/16" = 1'-0"

SYMBOL LEGEND

▲ TYPICAL CATEGORY 6 DATA/VOICE OUTLET.

AP TYPICAL WIRELESS ACCESS POINT DATA OUTLET.

PRECISION CABLING, INC.
STRUCTURED CABLING SYSTEMS & BEYOND...
Precision Cabling, Inc.
5501 Independence
Suite 310
Plano, TX 75023
www.precisioncablinginc.com

NORTHWOOD UNIVERSITY
HOPKINS

ISSUE RECORD

NO.	DATE	REVISION

KEYPLAN:

STRUCTURED
CABLE AS-BUILT
DOCUMENTATION

SHEET NO.

T1.00